

OFFICE OF THE MARION COUNTY SURVEYOR  
SECTION RECORD CORNER

SECTION 2 TOWNSHIP 14 RANGE 4

DATE: 4-1-05

PARTY CHIEF: Wilcoxon

CREW: \_\_\_\_\_

TYPE OF MARKER: Harrison monu. found



METHOD OF ESTABLISHMENT: County: 4-25-00

IN. S.P.C. E ZONE NAD '83

NAME: 14040204

N: 492994.2545(m)

E: 65954.8433(m)

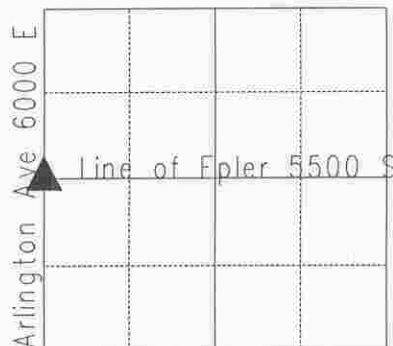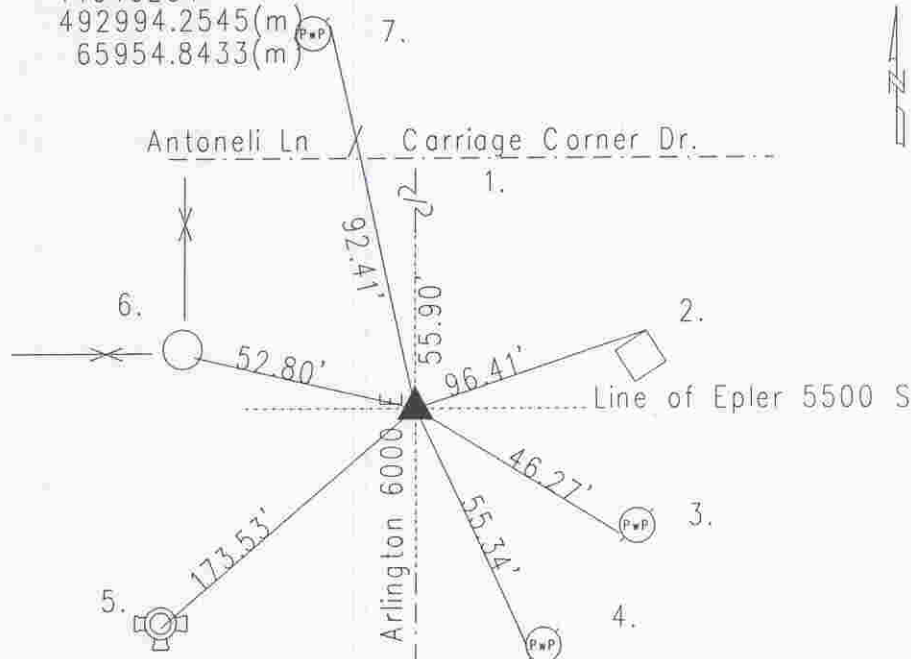

Original post set 1820 by Hendricks with witness: 16" ash N 46 W 3 links, 6" bee S 4 W 29 links per Marion County Atlas pg. 9. Hosbrook 6-4-1849 set rock at the original stake, with witness: 36" oak S 70 W 24 links. Original witness were called one green and one stump. Previously set found by Hosbrook per, Fatout 1-14-1885 per Franklin Township Legal Survey Book pg. 17. Tie card (no date) called stone. 6-21-52 called stone per Monroe. 9-11-68 Bookedis called PK nail. 4-14-70 McLand called PK nail. 8-21-79 Graham called PK nail at surface. 7-6-84 dug corner per Wilcoxon, stone found 8" down. Excavated 8-1-89 PK nail found 3" down. Rebar found 7" down. Stone found 8" down. Set Harrison. Re-tied 4-25-00 by Wilcoxon. Re-tied 4-1-05 by Wilcoxon.

14040204

REF.	DISTANCE	DESCRIPTION
1.	55.90'	Due N to C/I of Antoneli Lane
2.	96.41'	Northerly corner of brick post (Carriage House)
3.	46.27'	Mag nail SW side of PwP#467-736 10"up
4.	55.34'	Mag nail w/brass washer W PwP#76-736 12"up
5.	173.53'	Top nut of fire hydrant
6.	52.80'	Face of corner fence post
7.	92.41'	PK nail F light pole